



YORK PLACE[®]

COMPANY FORMATION • INFORMATION
ADMINISTRATION • PROPERTY SEARCHES

Date: 15 February 2010

Client Reference:

Case Reference:

Address:

Whilst every effort has been made to obtain as much information as possible, YorkPlace is dependent on the Data Provider for the accuracy and extent of the information supplied and accordingly cannot be held liable for inaccurate or incomplete information supplied to YorkPlace.

York Place, White Rose House, 28a York Place, Leeds LS1 2EZ

DX 26436 – Leeds Park Square

Tel: +44 (0)113 2245 450 Fax: +44 (0)113 2245498

Your ref -

In any reply quote

Payment for this request received with thanks.

Mapping Services
P.O. Box 6206
Basingstoke
Hampshire
RG24 8BW

Your local Depot is: READING
Arrowhead Road
Theale
Berkshire
RG7 4AH
Tel. 01189-126500
Fax. 01189-126506

York Place Ltd
White Rose House
28a York Place
Leeds LS1 2EZ

12/02/2010

Dear Sir/Madam

In response to your enquiry of 10/2/10 regarding the location of electricity cables and equipment at the above, copies of our Record Plans are enclosed.

The plans show the positions and normal depths for the buried cables etc. when they were installed. It must be stressed, however, that alterations to road alignments, surface levels and buildings may have been made subsequent to the records being taken. If you find plant or cables that are not marked or are incorrectly marked, then you are required to contact us as soon as possible to give us the opportunity to amend our records.

It has not been possible to transfer our mains records onto your plan. Please note that the plans supplied are based on the location/map information supplied by yourselves and, therefore, YOU MUST SATISFY YOURSELF THAT OUR PLANS SUPPLIED ADEQUATELY COVER THE AREA THAT YOU REQUIRE.

Please note that these records only show plant owned by Scottish and Southern Energy plc. There may be other privately owned plant in the area, which is outside the control of Scottish and Southern Energy plc. You should check with the Local Authority, National Grid Co., Department of the Environment, other Regional Electricity companies etc. before proceeding.

Avoidance of DANGER from BURIED CABLES


For more information, consult the Health & Safety Executive's booklet HS(G) 47 - obtainable from the HMSO. Guidance notes are contained in Scottish and Southern Energy's 'Watch-It' leaflet, which sets out various do's and don'ts when digging near buried cables.

I would particularly draw your attention to the need to take trial holes to determine the exact position and depth of cables to avoid the risk of injury to staff or damage to the cables.

Where our Record plans indicate the presence of cables with a voltage exceeding 11,000 volts then you are advised to contact our Local Depot section on the above telephone number before commencing any excavations within the vicinity of these cables.

Avoidance of DANGER from OVERHEAD LINES

For more information, consult the Health and Safety Guidance Note GS.6 obtainable from HMSO.
SSE Power Distribution is a trading name of: SSE Power Distribution Limited Registered in Scotland No. 213459; Scottish Hydro Electric Transmission Limited Registered in Scotland No. 213460; Scottish Hydro Electric Power Distribution plc Registered in Scotland No. 213460; S+S Limited Registered in Scotland No. 214382 (all having their Registered Offices at Inverlorn House 200 Dunkeld Road Perth PH1 3AQ); and Southern Electric Power Distribution plc Registered in England and Wales No. 4094290 having its Registered Office at 55 Vastern Road Reading RG1 8BU which are members of the Scottish and Southern Energy Group
www.scottish-southern.co.uk

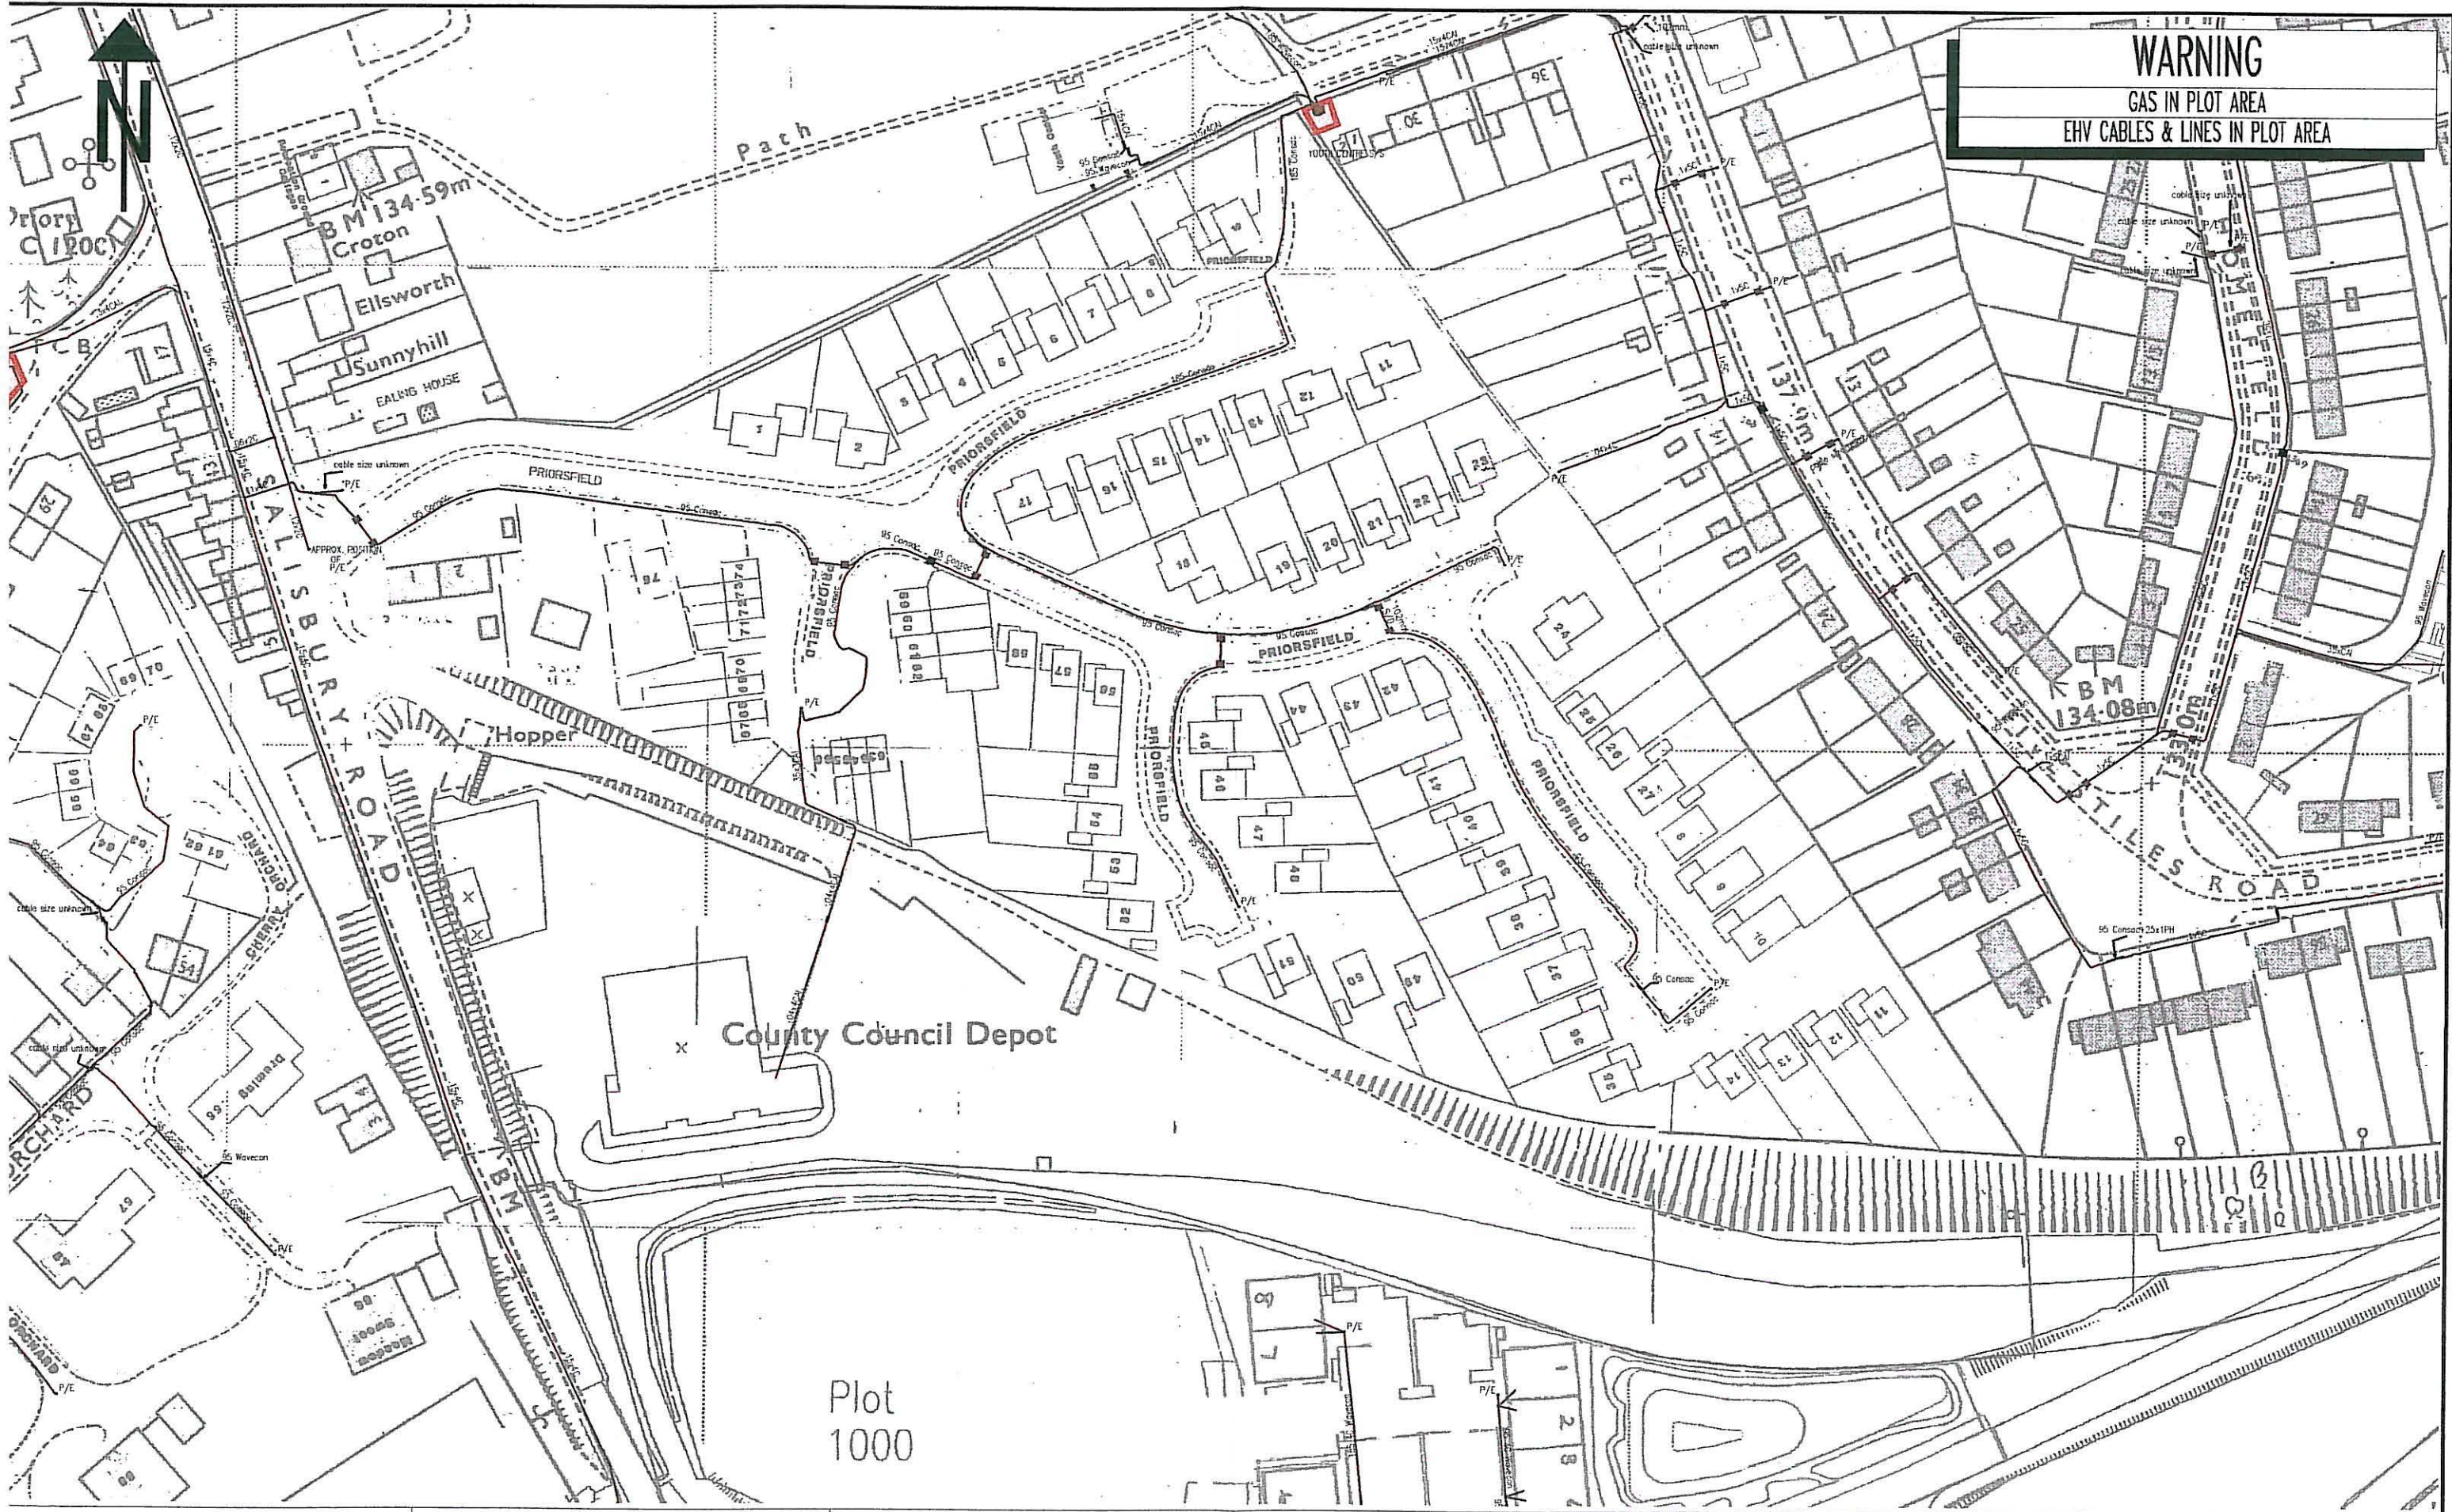

WARNING
GAS IN PLOT AREA
EHV CABLES & LINES IN PLOT AREA

NORMAL DEPTH TO THE TOP OF THE CABLE WHEN LAID			
	services	l.v.	h.v. e.h.v.
FOOTPATH	0.40m	0.45m	0.60m 0.75m
ROAD CROSSING	0.60m	0.60m	0.75m 0.90m
l.v./services	- up to 1000V.		
h.v.	- over 1000V. to 11,000V.		
e.h.v.	- 22,000V. to 132,000V.		

WARNING

There may have been subsequent alterations to the surface levels. Trial holes must be taken to determine positions and depth of cables. BS (G) 47 Booklet from the Health and Safety Executive - Avoiding Danger from Buried Cables - should be consulted before commencing excavation work. (available from HSE)


WHEN WORKING IN THE VICINITY OF OVERHEAD LINES THE HEALTH AND SAFETY GUIDANCE NOTE CS6 SHOULD BE CONSULTED. (AVAILABLE FROM HSE)


BASED UPON THE ORDNANCE SURVEY MAP WITH THE SANCTION OF THE CONTROLLER OF H.M. STATIONERY OFFICE. CROWN COPYRIGHT RESERVED.

This copy has been made by or with the authority of SOUTHERN ELECTRIC plc pursuant to section 47 of the Copyright, Designs and Patents Act 1988 ("the Act"). Unless the Act provides a relevant exemption to copyright, the copy must not be copied without the prior permission of the copyright owner.

Scottish and Southern Energy plc.
Registered in Scotland No 117119.
Registered Office, Inverlind House
200 Dunkeld Road,
Perth, PH1 3AQ.

UNCONTROLLED COPY
Subject to Revision Master held at

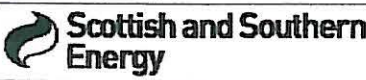	
L.V. MAINS RECORD	Grid Ref:
	Scale: 1:1250
	Date: 12/02/2010

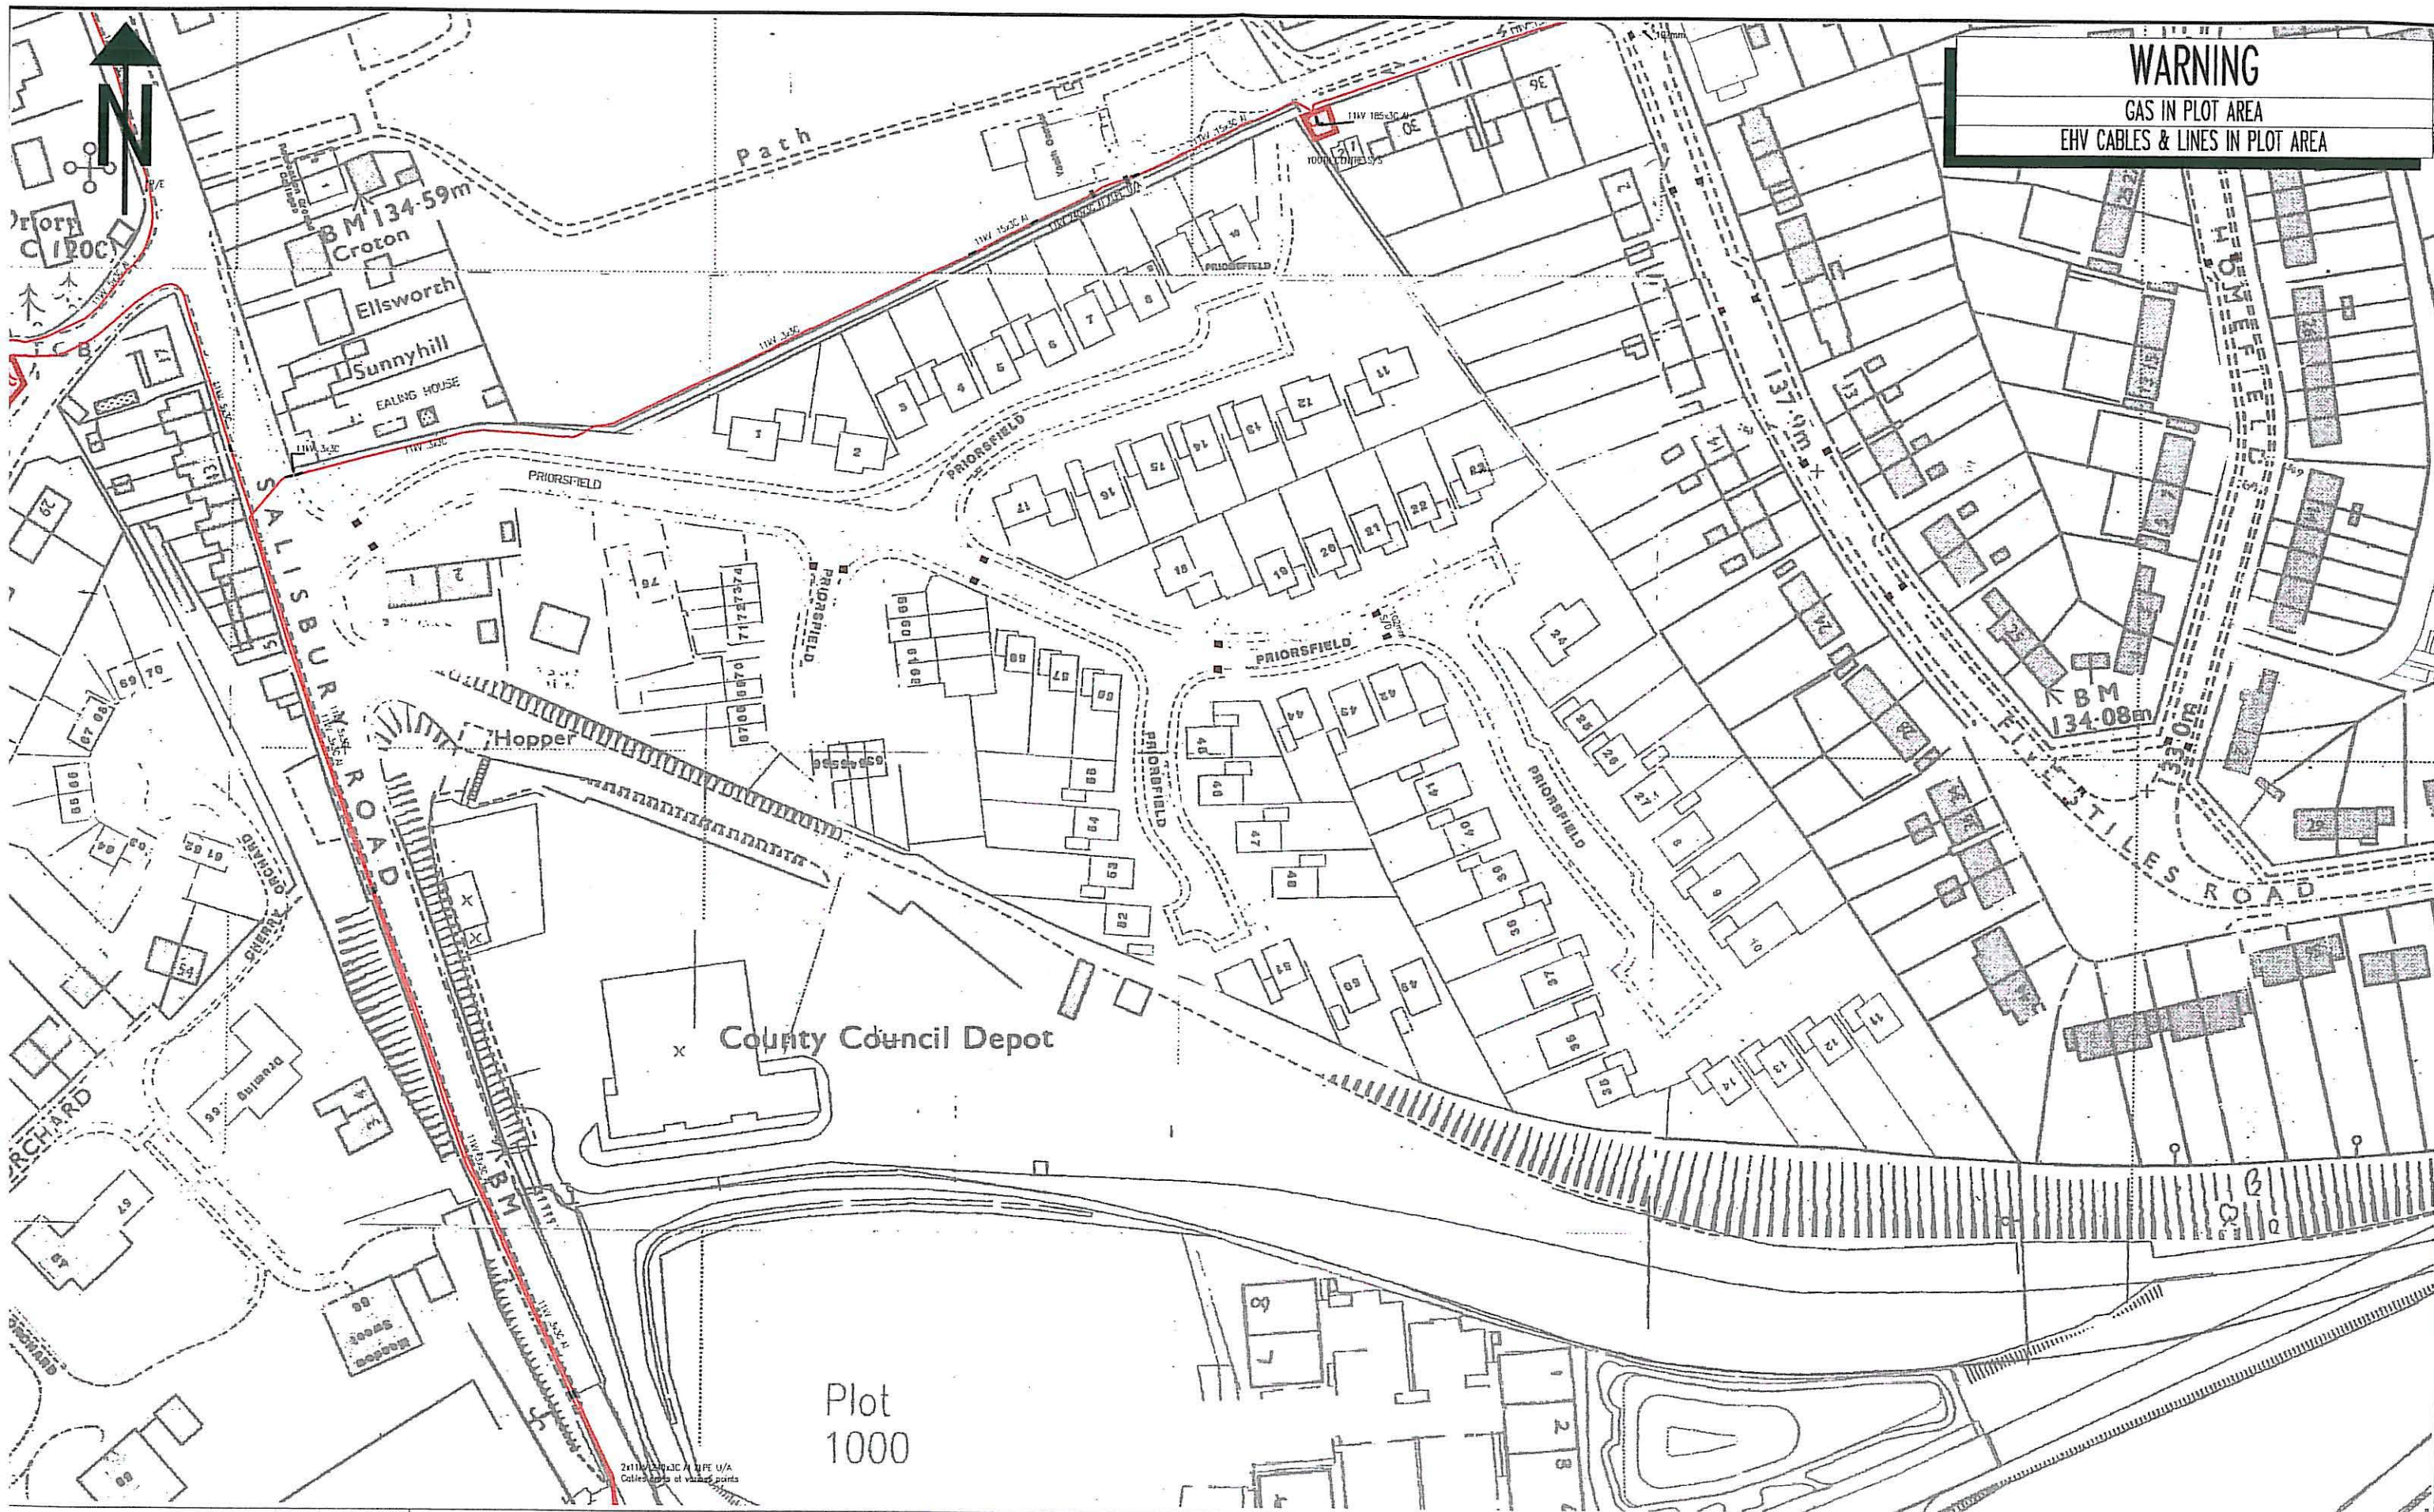

NORMAL DEPTH TO THE TOP OF THE CABLE WHEN LAID			
	services	l.v.	h.v.
FOOTPATH	0.40m	0.45m	0.60m
ROAD CROSSING	0.60m	0.60m	0.75m
l.v./services	- up to 1000V.		
h.v.	- over 1000V. to 11,000V.		
e.h.v.	- 22,000V. to 132,000V.		

WARNING

There may have been subsequent alterations to the surface levels. Trial holes must be taken to determine positions and depth of cables. BS (G) 47 Booklet from the Health and Safety Executive - Avoiding Danger from Buried Cables - should be consulted before commencing excavation work. (available from HMSO)


WHEN WORKING IN THE VICINITY OF OVERHEAD LINES THE HEALTH AND SAFETY GUIDANCE NOTE CSO SHOULD BE CONSULTED. (AVAILABLE FROM HMSO)

BASED UPON THE ORDNANCE SURVEY MAP WITH THE SANCTION OF THE CONTROLLER OF H.M. STATIONERY OFFICE. CROWN COPYRIGHT RESERVED.

This copy has been made by or with the authority of SCOTTISH ELECTRIC plc. pursuant to section 47 of the Copyright, Designs and Patents Act 1988 ("the Act"). Unless the Act provides a relevant exception to copyright, the copy must not be copied without the prior permission of the copyright owner.

Scottish and Southern Energy plc.
Registered in Scotland No 117119.
Registered Office: Inverleith House
250 Dundee Road,
Perth, PH1 3AQ.

UNCONTROLLED COPY
Subject to Revision Master held at

 **Scottish and Southern Energy**

H.V. MAINS RECORD

Grid Ref:
Scale: 1:1250
Date: 12/02/2010